

STORMWATER DRAINAGE PLAN - I



MONTGOMERY WATSON
Pasadena, California

PROJECT
STORMWATER BEST
MANAGEMENT PRACTICES
DEMONSTRATION PROJECT
PHASE I

SCHOOL
BROADOUS E.S.
12561 FILMORE STREET
PACOMA, CA 91331

D.S.A. STAMP


**NOT
APPROVED
FOR
CONSTRUCTION**



DESIGN & INSPECTION BRANCH
FACILITIES SERVICES DIVISION

355 NORTH GRAND AVENUE
LOS ANGELES, CALIFORNIA

DATE	13-SEP-2000
INDEX NO.	II
CHECKED BY	C.A. GANTNEY
TRAINING NO.	C-10
JOB NUMBER	
TRAINING BY	S. STONE
REVISIONS	

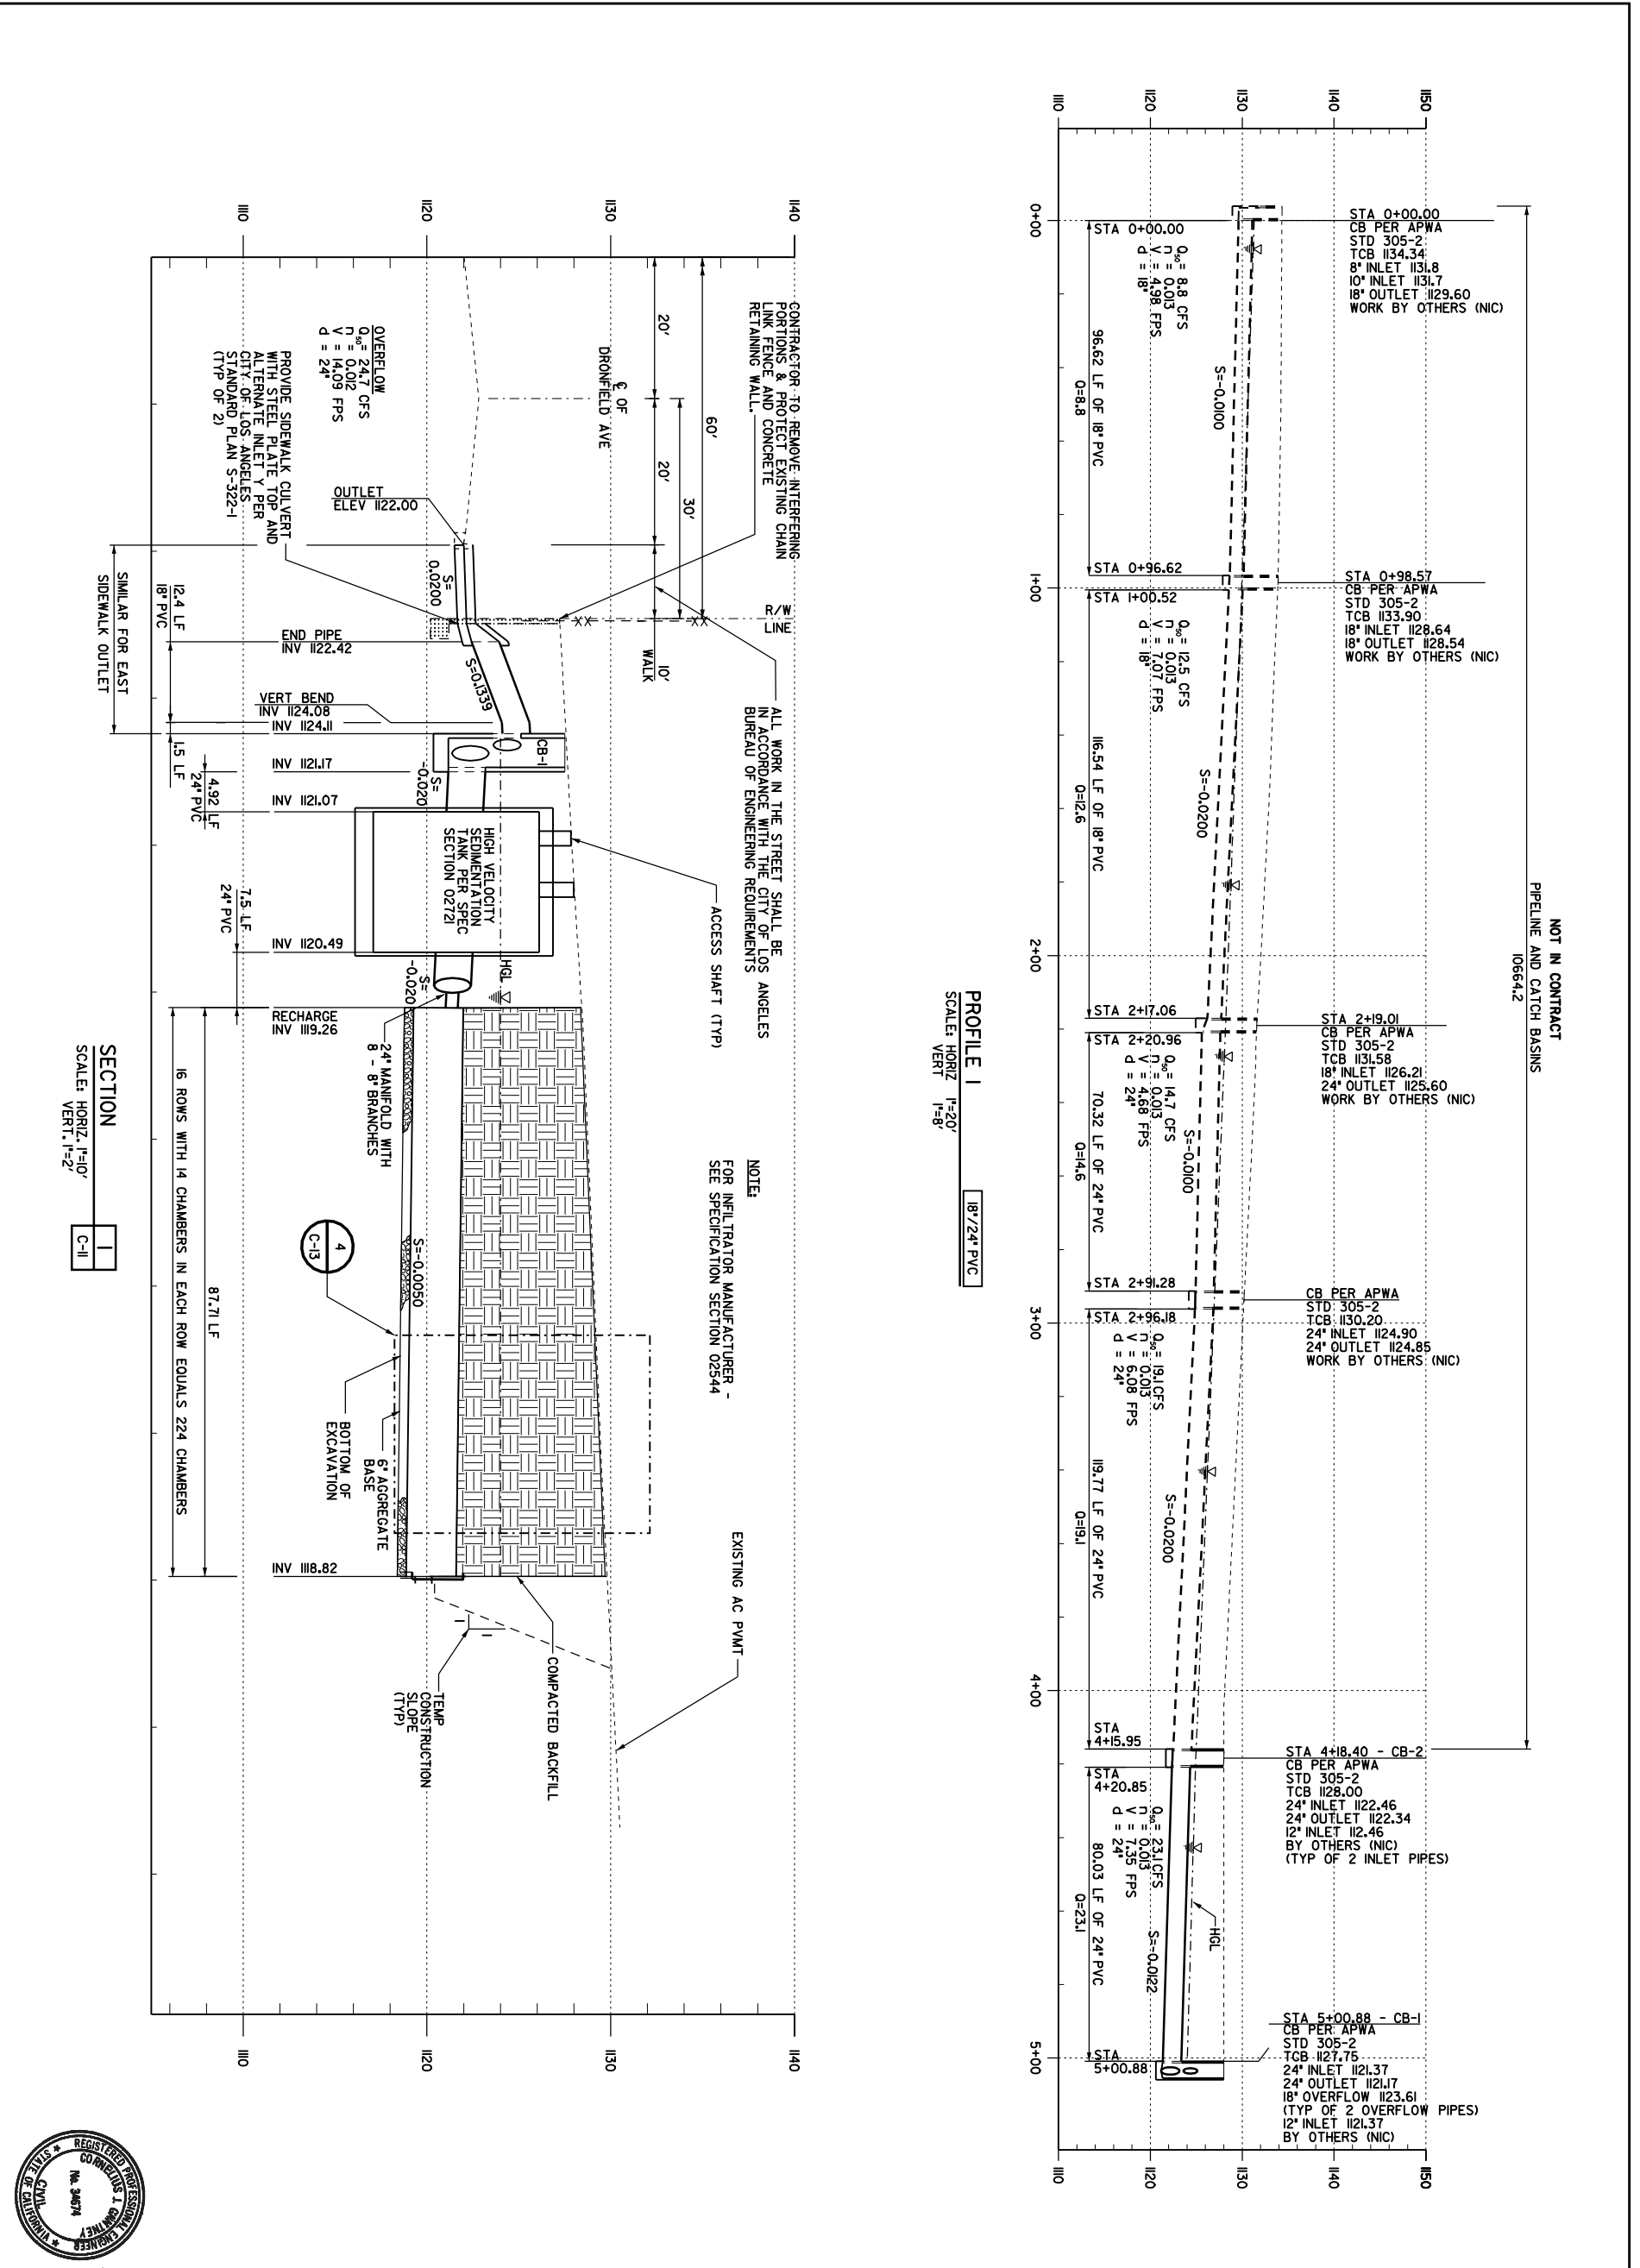

STORMWATER DRAINAGE PLAN - SECTIONS



PROJECT: STORMWATER BEST MANAGEMENT PRACTICES DEMONSTRATION PROJECT PHASE I

SCHOOL: BROADOUS E.S. 12561 FILMORE STREET PACOIMA, CA 91331

D.S.A. STAMP

NOT APPROVED FOR CONSTRUCTION



DESIGN & INSPECTION BRANCH
FACILITIES SERVICES DIVISION
355 NORTH GRAND AVENUE
LOS ANGELES, CALIFORNIA

DATE	13-SEP-2000
INDEX NO.	13
CHECKED BY	C.A. GANTNEY
TRAINING NO.	C-12
DESIGNED BY	S. STONE
JOB NUMBER	
REVISIONS	

